



# Armor-Tile™

## Transit Systems

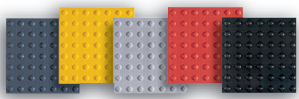

FILE# \$  
 USER# \$  
 DATE# \$  
 TIME# \$

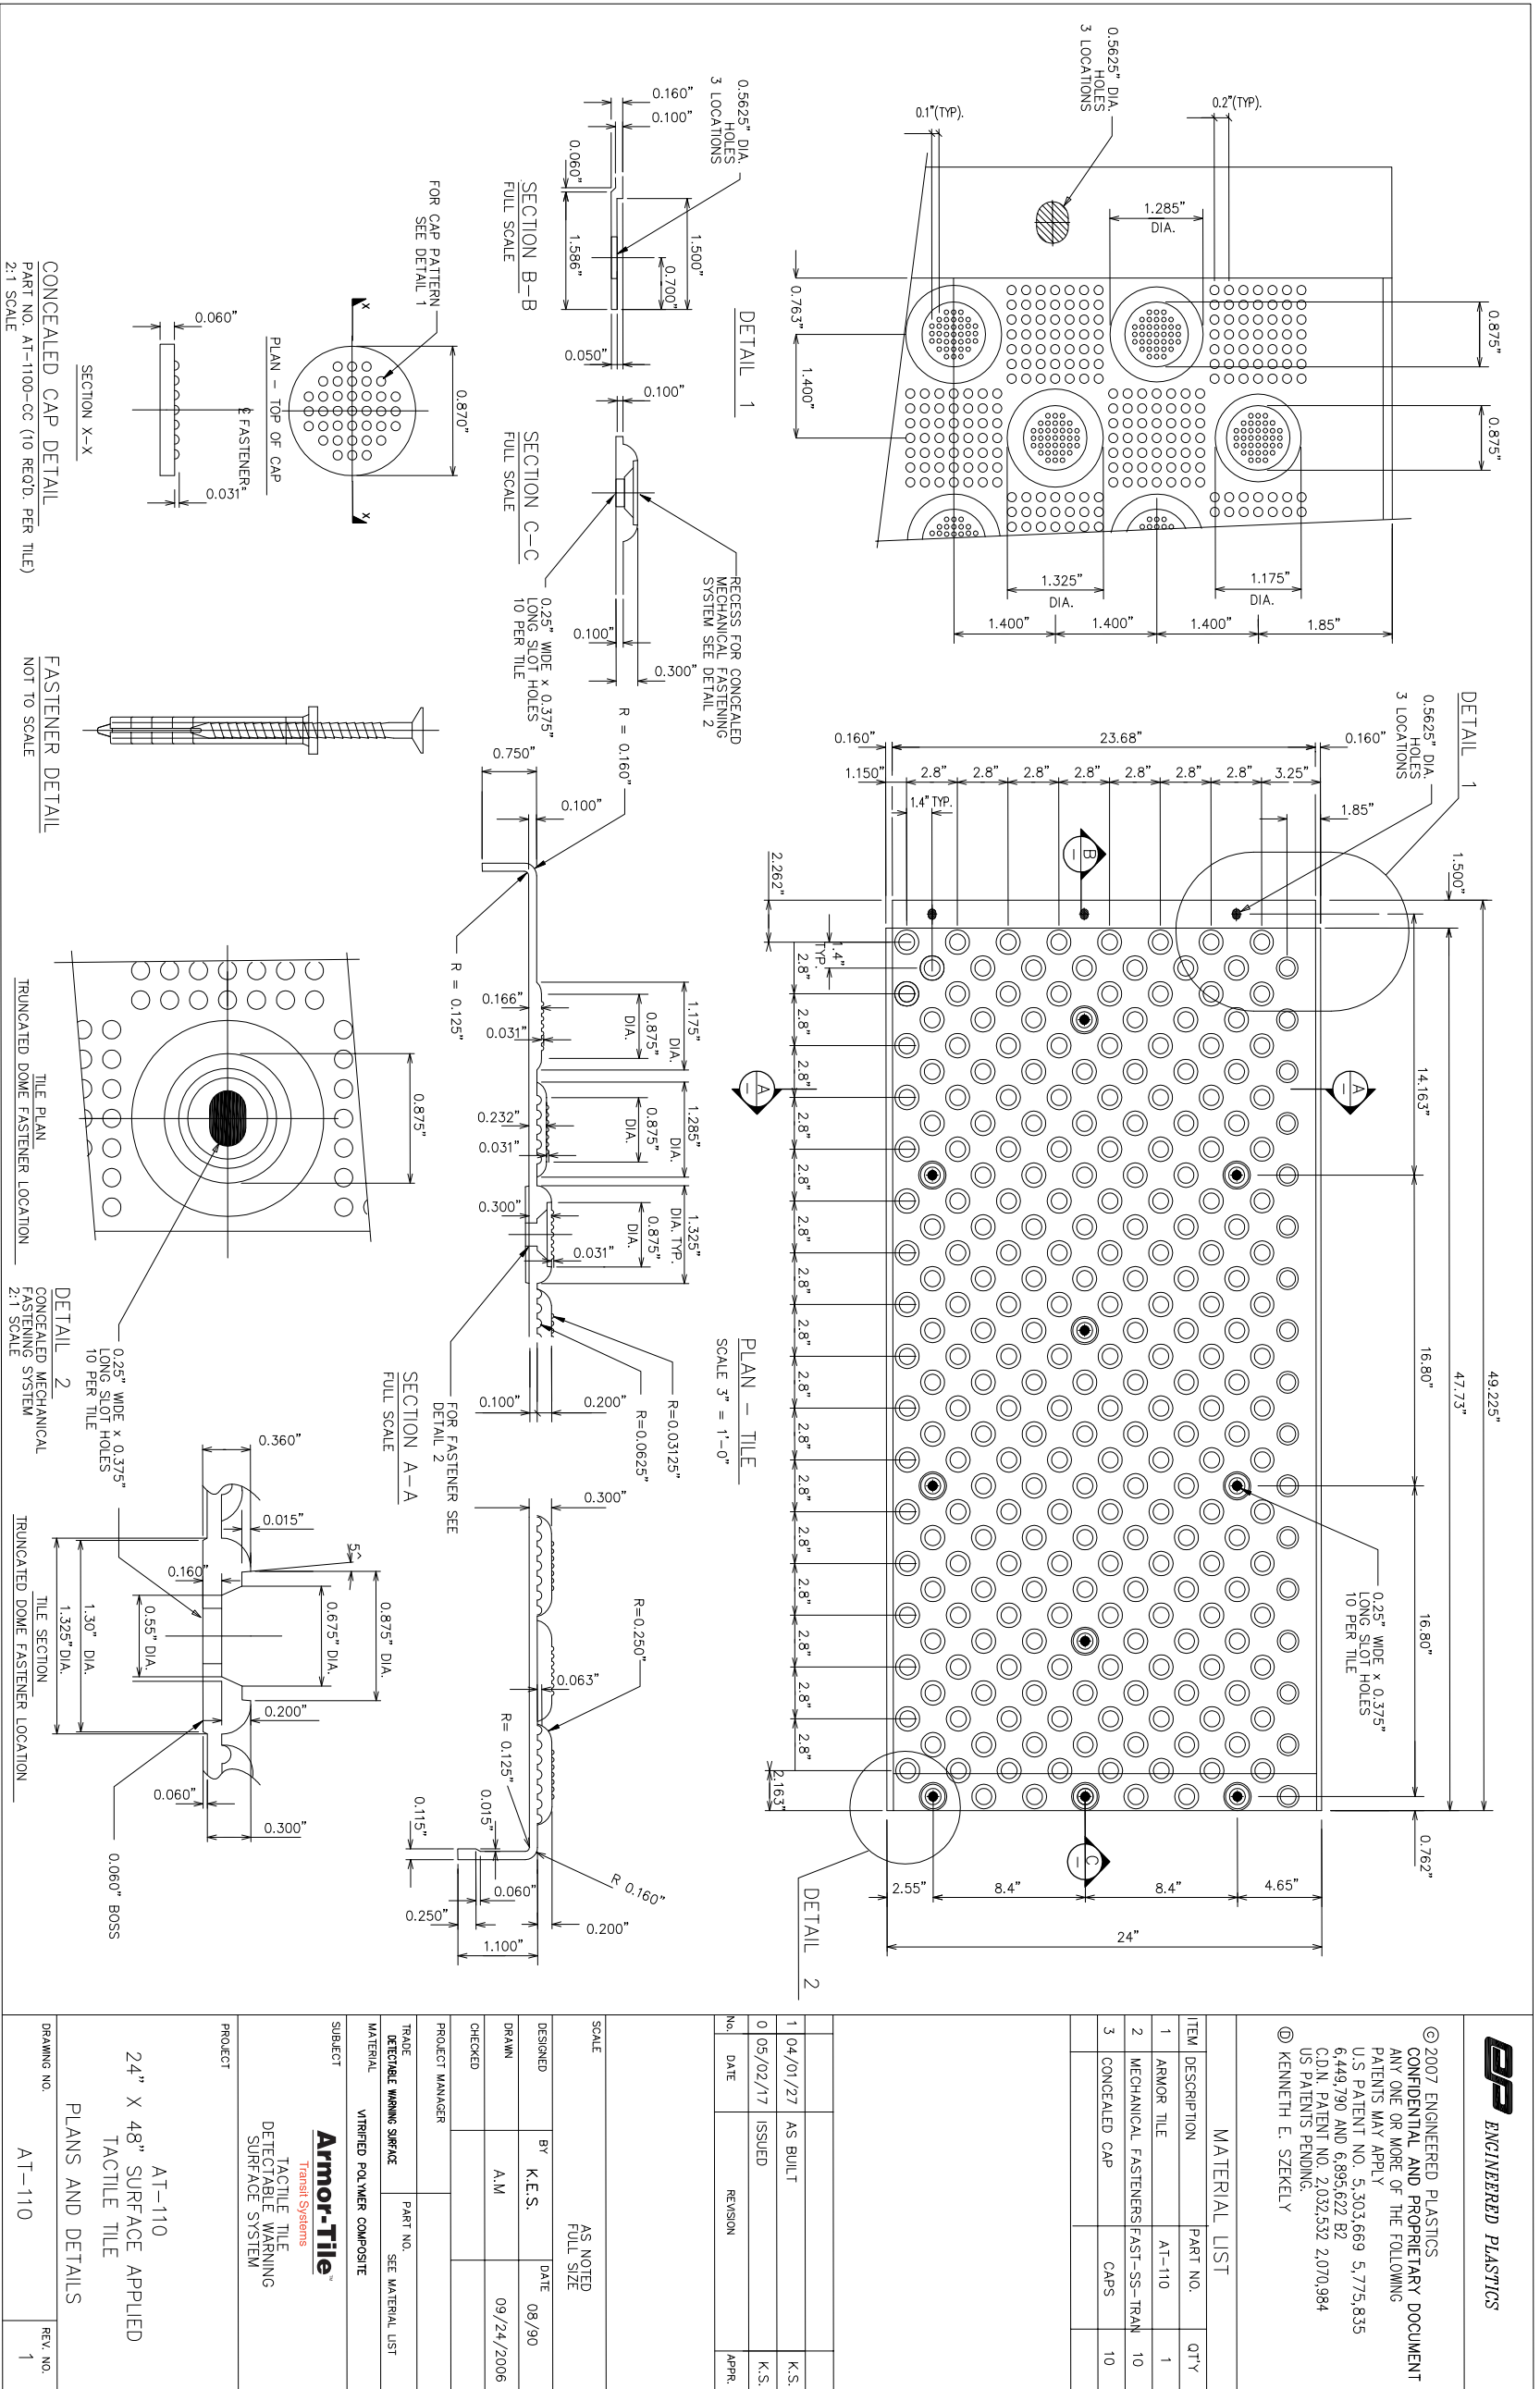

**EP ENGINEERED PLASTICS**

© 2007 ENGINEERED PLASTICS  
 CONFIDENTIAL AND PROPRIETARY DOCUMENT  
 ANY ONE OR MORE OF THE FOLLOWING  
 PATENTS MAY APPLY  
 U.S. PATENT NO. 5,303,669 5,775,835  
 6,449,790 AND 6,895,622 B2  
 C.D.N. PATENT NO. 2,052,532 2,070,984  
 U.S. PATENTS PENDING.  
 Ⓢ KENNETH E. SZEKELY

**MATERIAL LIST**

| ITEM | DESCRIPTION                         | PART NO.     | QTY |
|------|-------------------------------------|--------------|-----|
| 1    | ARMOR TILE                          | AT-110       | 1   |
| 2    | MECHANICAL FASTENERS (FAST-SS-TRAN) | FAST-SS-TRAN | 10  |
| 3    | CONCEALED CAP                       | CAPS         | 10  |

| NO. | DATE     | REVISION | APPR. |
|-----|----------|----------|-------|
| 1   | 04/01/27 | AS BUILT | K.S.  |
| 0   | 05/02/17 | ISSUED   | K.S.  |

|                 |   |
|-----------------|---|
| SCALE           | AS NOTED<br>FULL SIZE   |
| DESIGNED        | BY K.E.S. DATE 08/90  |
| DRAWN           | A.M. 09/24/2006   |
| CHECKED         |   |
| PROJECT MANAGER |   |
| TRADE           | DETECTABLE WARNING SURFACE  |
| MATERIAL        | VITRIFIED POLYMER COMPOSITE   |
| SUBJECT         | <b>Armor-Tile™</b><br>Transit Systems<br>TACTILE TILE<br>DETECTABLE WARNING<br>SURFACE SYSTEM |
| PROJECT         | AT-110<br>24" X 48" SURFACE APPLIED<br>TACTILE TILE<br>PLANS AND DETAILS                      |
| DRAWING NO.     | AT-110  |
| REV. NO.        | 1   |

Toll Free: 1-800-682-2525  
 Email: info@armortiletransit.com

[www.armortiletransit.com](http://www.armortiletransit.com)