



# Armor-Tile™

## Transit Systems

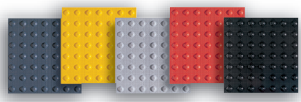

FILE# \$  
 USER# \$  
 DATE# \$  
 TIME# \$

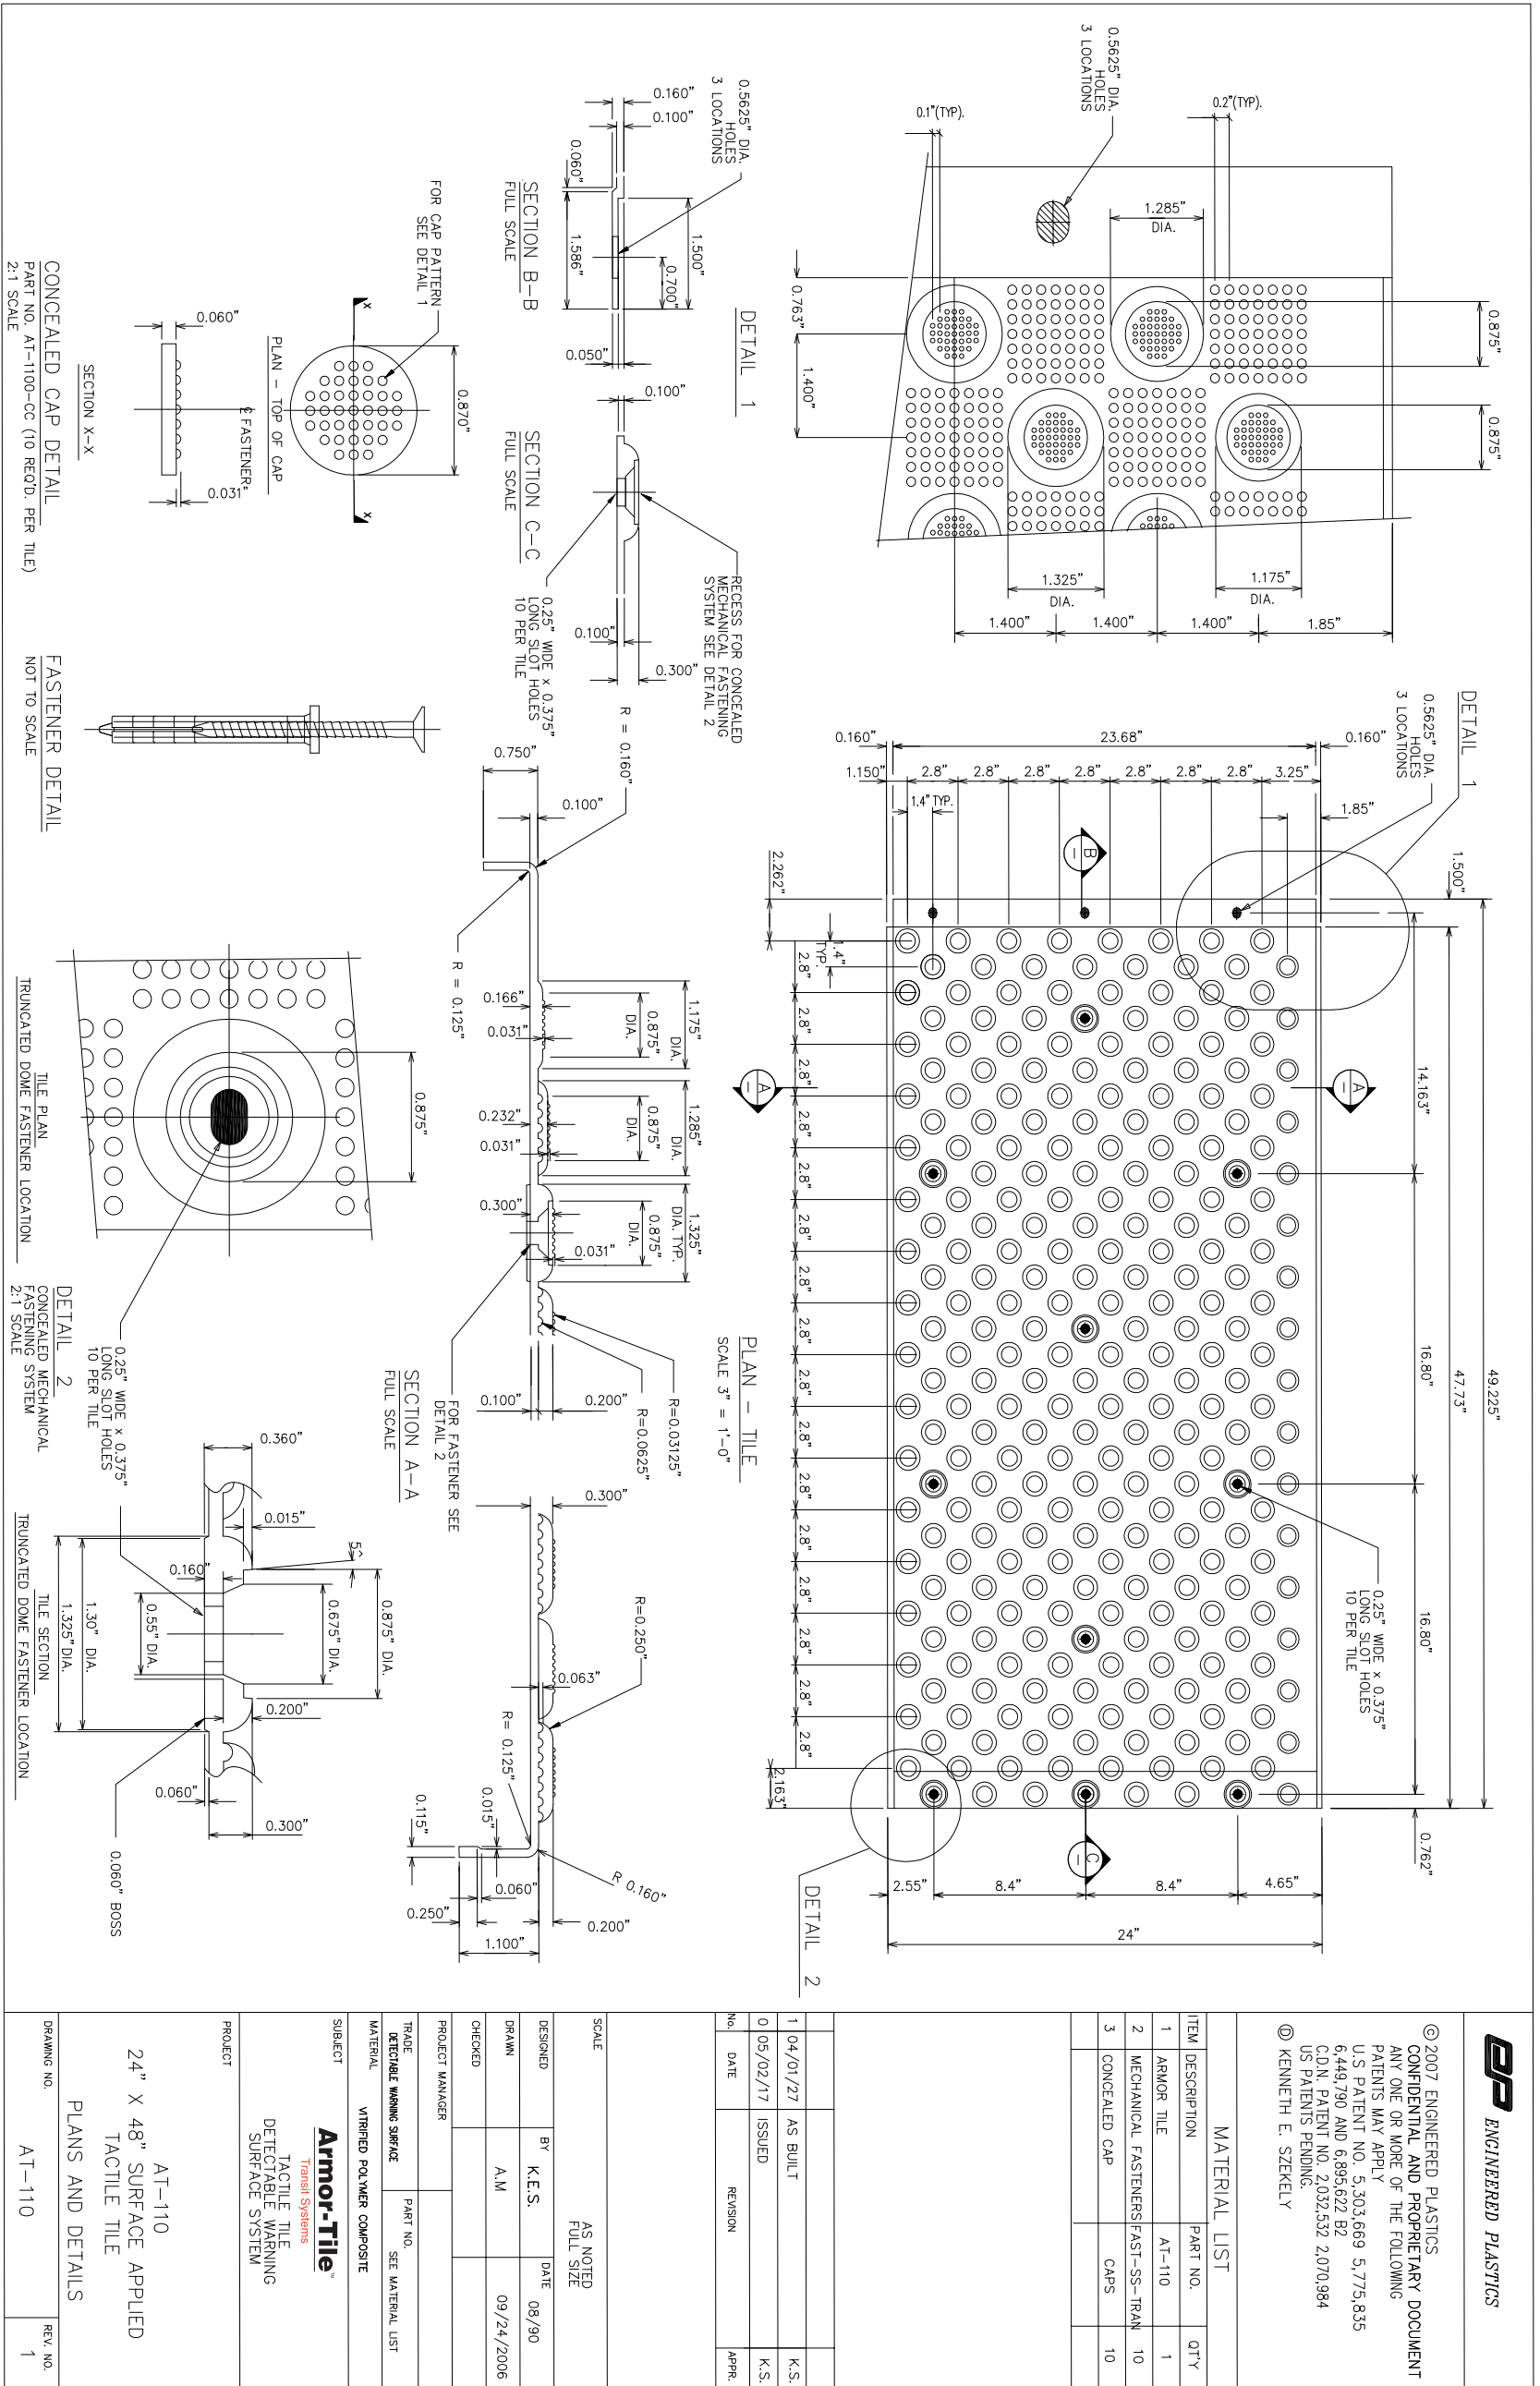

**EP** ENGINEERED PLASTICS

© 2007 ENGINEERED PLASTICS  
 CONFIDENTIAL AND PROPRIETARY DOCUMENT  
 ANY ONE OR MORE OF THE FOLLOWING  
 PATENTS MAY APPLY  
 U.S. PATENT NO. 5,303,669 5,775,835  
 6,449,790 AND 6,895,622 B2  
 C.D.N. PATENT NO. 2,052,552 2,070,984  
 U.S. PATENTS PENDING.  
 Ⓢ KENNETH E. SZEKELY

**MATERIAL LIST**

ITEM	DESCRIPTION	PART NO.	QTY
1	ARMOR TILE	AT-110	1
2	MECHANICAL FASTENERS (FAST-SS-TRAN)	FAST-SS-TRAN	10
3	CONCEALED CAP	CAPS	10

NO.	DATE	REVISION	APPR.
1	04/01/27	AS BUILT	K.S.
0	05/02/17	ISSUED	K.S.

SCALE	AS NOTED FULL SIZE
DESIGNED	BY K.E.S. DATE 08/90
DRAWN	BY A.M. DATE 09/24/2006
CHECKED	
PROJECT MANAGER	
TRADE	DETECTABLE WARNING SURFACE
MATERIAL	VITRIFIED POLYMER COMPOSITE
SUBJECT	<b>Armor-Tile™</b> Transit Systems TACTILE TILE DETECTABLE WARNING SURFACE SYSTEM
PROJECT	AT-110 24" X 48" SURFACE APPLIED TACTILE TILE PLANS AND DETAILS
DRAWING NO.	AT-110
REV. NO.	1

Toll Free: 1-800-682-2525  
 Email: info@armortiletransit.com

[www.armortiletransit.com](http://www.armortiletransit.com)